## COUNTY OF VENTURA DEPARTMENT OF AIRPORTS

November 09, 2012

ADDENDUM No. 1

From:

Todd McNamee, Director of Airports

To:

All Prospective Bidders

Subject:

Project Name: Camarillo Airport -

295 DURLEY AVENUE BUILDING IMPROVEMENTS

Specification No:

**DOA 13-02** 

Project No:

**CMA-185** 

Bid Opening Date: TUESDAY, November 20, 2012 ORIGINAL DATE

Make the following modification to the bidding documents for subject project:

Note: As a result of Building & Safety, Plan Check and Pre-Bid Conference comments, the PLAN SHEET A2.2 has been modified. The following are modifications to the PLANS:

## BID ITEM No. 1:


- 1. PLAN SHEET A2.2 DETAIL 1, Demolition Restrooms "Add NOTE 17".
- 2. PLAN SHEET A2.2 DETAIL 2, Proposed Restrooms "Add NOTES 27 & 28".
- 3. PLAN SHEET A2.2 DETAIL 4, Proposed Break Room "Revise NOTE 16".

## **BID ITEM No.2:**


PLAN SHEET A2.2 - DETAIL 3, Proposed - Bait Room "Add NOTES 29 & 30".


NOTE: Reflect the costs for the changes under the appropriate BID ITEM!

ATTACHMENT: PLAN SHEET A2.2, Revised

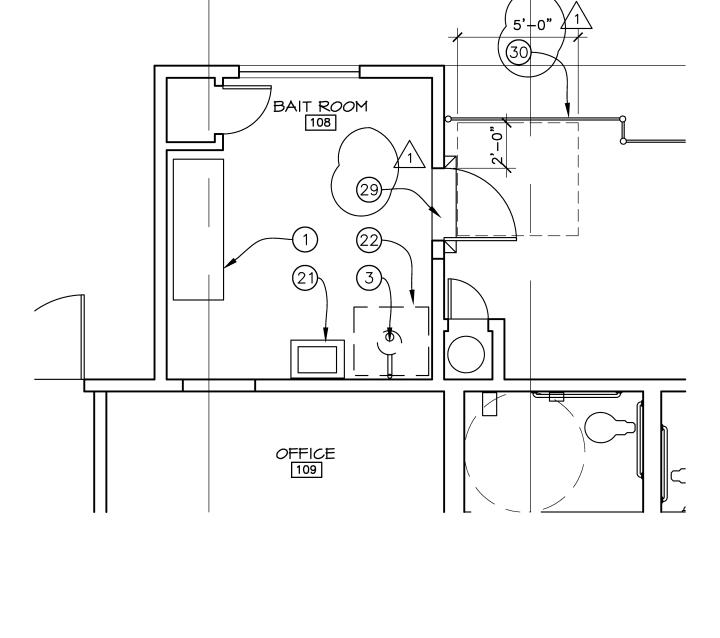




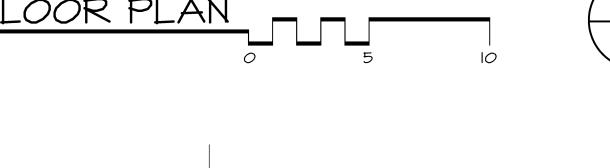


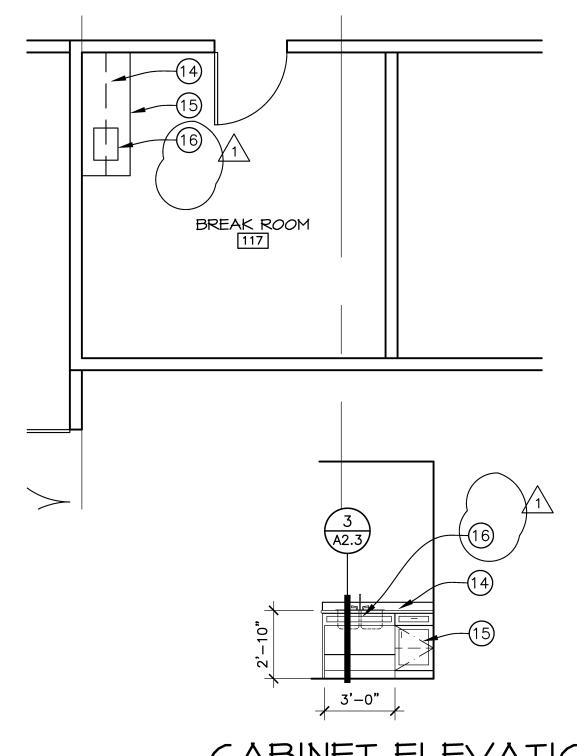


CABINET ELEVATION SCALE 1/4" : 1'-0"



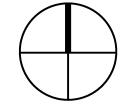

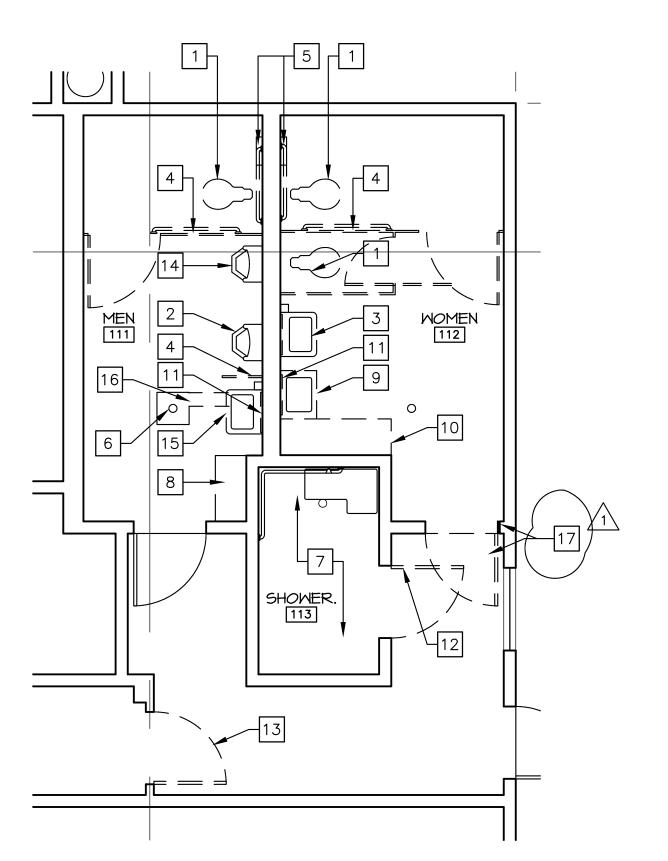



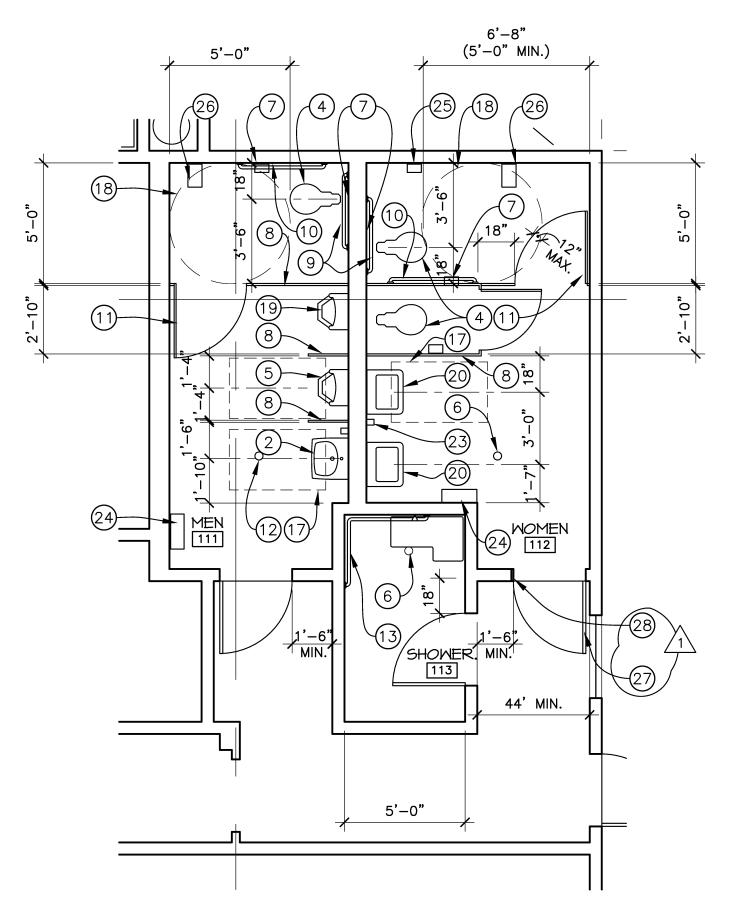





- I. EXISTING WATER CLOSETS TO BE REMOVED.
- 2. EXISTING URINAL TO BE REMOVED.
- 3. EXISTING WALL MOUNT SINK TO BE RELOCATED.
- 4. EXISTING TOILET PARTITIONS, PRIVACY SCREENS TO BE REMOVED.
- 5. EXISTING GRAB BARS, TOILET ACCESSORIES, SOAP DISPENSERS TO BE
- 6. IMMEDIATE TILED AREA AT FLOOR DRAIN TO BE REMOVED TO RAISE EXISTING FLOOR DRAIN.
- 7. EXISTING SHOWER GRAB BARS, SEAT, SHOWER HEAD, FLOOR DRAIN, ALL EXISTING TILED WALL FINISHES TO REMAIN.
- 8. EXISTING BASE CABINET TO BE REMOVED.
- 9. EXISTING BASE CABINET, COUNTER MOUNT SINK TO BE REMOVED.
- IO. EXISTING COUNTER TO BE REMOVED.
- II. EXISTING WALL MIRROR TO BE RELOCATED.
- 12. EXISTING DOOR TO BE REMOVED, REINSTALLED.
- 13. EXISTING DOOR TO BE REMOVED. FRAME TO REMAIN.
- 14. EXISTING URINAL TO REMAIN
- 15. EXISTING WALL MOUNT SINK TO BE RELOCATED TO "WOMENS".
- 16. REMOVE EXISTING FLOOR TILE, SAWCUT EXISTING CONCRETE SLAB FOR INSTALLATION OF TRAP PRIMER. SEE PLUMBING DRAWINGS.
- REMOVE EXISTING DOOR AND ALUMINUM DOOR FRAME, WALL FRAMING AS REQUIRED TO PROVIDE MINIMUM 18" CLEARANCE ON STRIKE SIDE OF DOOR. SEE PROPOSED PLANS.

## PROPOSED NOTE LEGEND

- I. FUME HOOD. SEE MECHANICAL DRAWINGS.
- 2. NEW WALL MOUNTED SINK, ACCESSIBLE CONTROLS, INSULATED HOT WATER AND DRAIN LINES.
- 3. EMERGENCY WASH OFF SHOWER AND FLOOR DRAIN. SEE PLUMBING DRAWINGS.
- 4. NEW FLOOR MOUNT WATER CLOSET.
- 5. NEW ACCESSIBLE URINAL.
- 6. EXISTING FLOOR DRAIN TO REMAIN.
- 7. RELOCATED TOILET SEAT DISPENSER AND TOILET PAPER DISPENSER. TYPICAL AT TOILET STALLS. SEE DETAIL FOR TYPICAL MOUNTING HEIGHTS, LOCATIONS.
- 8. REPLACEMENT METAL TOILET PARTITIONS, DOORS AND URINAL PANELS.
- 9. RELOCATED 36" LONG I-I/2" O.D. GRAB BAR MOUNTED I-I/2" FROM WALL AND
- 10. RLOCATED 42" LONG 1-1/2" O.D. GRAB BAR MOUNTED 1-1/2" FROM WALL AND 33" A.F.F. TYP.
- II. 3'-0" WIDE METAL COMPARTMENT DOOR WITH SELF CLOSER, U-SHAPED HANDLE OR LOOP TO OPERATE THE DOOR, MAX, MUM PRESSURE TO OPERATE THE DOOR DOES NOT EXCEED 5 LBF.
- 12 EXISTING DRAIN LOCATION. RAISE DRAIN TO 1/4" BELOW FINISHED FLOOR. PATCH, REPAIR FLOOR AS REQUIRED.
- 13 EXISTING SHOWER GRAB BARS, SEAT, SHOWER HEAD TO REMAIN.
- 14 REINSTALLED EXISTING STONE COUNTER TOP AND SPLASH.
- IS REMOVE EXISTING OAK WOOD BASE CABINET. PROVIDE ACCESSIBLE OAK WOOD BASE CABINET TO MATCH EXISTING. INSTALL OWNERS UPPER



EXISTING COUNTER MOUNT SINK TO BE REPLACED. PROVIDE REPLACEMENT STAINLESS STEEL COUNTER MOUNT SINK, APPROIXIMATE 32"x22"x7" DEEP, SINGLE HOLE. REPLACEMENT SINK DRAIN AND REINSTALLED GARBAGE DISPOSAL TO BE LOCATED TO ALLOW ACCESSIBLE KNEE CLEARANCE PER DETAIL 3/A3.3.

- 17 CLEAR 30" X 48" AREA. TYP.
- 18 CLEAR 5'-O" RADIUS AREA. TYP.
- 19 EXISTING URINAL.
- 20 RELOCATED WALL MOUNT SINK, ACCESSIBLE CONTROLS, INSULATED HOT WATER AND DRAIN LINES.
- 21. UTILITY SINK WITH ACCESSIBLE CONTROLS.
- 22. APPROIXIMATE 3'-O" X 3'-O" AREA OF EXISTING CONCRETE FLOOR TO BE REMOVED. PROVIDE REPLACEMENT CONCRETE SUBFLOOR, SLOPE 2% TO NEW DRAIN. TIE REPLACEMENT SUBFLOOR TO EXISTING.
- 23. SURFACE MOUNT SOAP DISPENSER.
- 24 SURFACE MOUNT PAPER TOWEL AND TRASH RECEPTACLE.
- 25. SANITARY NAPKIN DISPENSER.
- 26. FOLDING STAINLESS STEEL UTILITY SHELF ALL ALL TOILET STALLS. TYP.
- 27.) REINSTALL EXISTING DOOR, ALUMINUM DOOR FRAME TO PROVIDE MINIMUM /IB" CLEARANCE ON STRIKE SIDE OF DOOR. REPLACEMENT WOOD TRIM MAY BE SUBSTITUTED FOR THE EXISTING ALUMINUM SNAP ON CASING IF THE RELOCATED DOOR FRAME DOES NOT ALLOW CLEARANCE FOR REINSTALLATION OF THE EXISTING ALUMINUM CASING. REPLACEMENT WOOD CASING TO BE PAINTED. PATCH AND REPAIR FLOOR FINISH, ADJACENT WALL SURFACES AS REQUIRED.
- 28) WALL FRAMING AT STRIKE SIDE OF DOOR TO PROVIDE MINIMUM 18" WALL CLEARANCE AT STRIKE SIDE OF DOOR.
- 29. PROVIDE REPLACEMENT EXTENDED THRESHOLD AT EXISTING 1-1/2" STEP. SEE DETAIL 2/A2.3 FOR ADDITIONAL THRESHOLD REQUIREMENTS.
- 30 REMOVE AND REINSTALL PORTION OF THE EXISTING GALVANIZED CHAIN LINK FENCE AND POST TO PROVIDE MINIMUM 2'-O" CLEARANCE ON STRIKE SIDE OF DOOR TO 5'-O" FROM DOOR.

SPEC. NUMBER 295 DURLEY DOA-13-02 PROJECT NUMBER DRAWING NUMBER CMA-185 913-DOA

S

MUS tectur

BUILDING IMPROVEM DURLE

295 DI BUILDIN VENTUR/ 555 AIRF CAMARIL

Sheet No.

**A2.2**